


DRAWING NUMBER  
H2122-01  
H2123-01



THIRD ANGLE PROJECTION

DO NOT SCALE

NOTE: TO BE ANNEALED BEFORE PLATING.

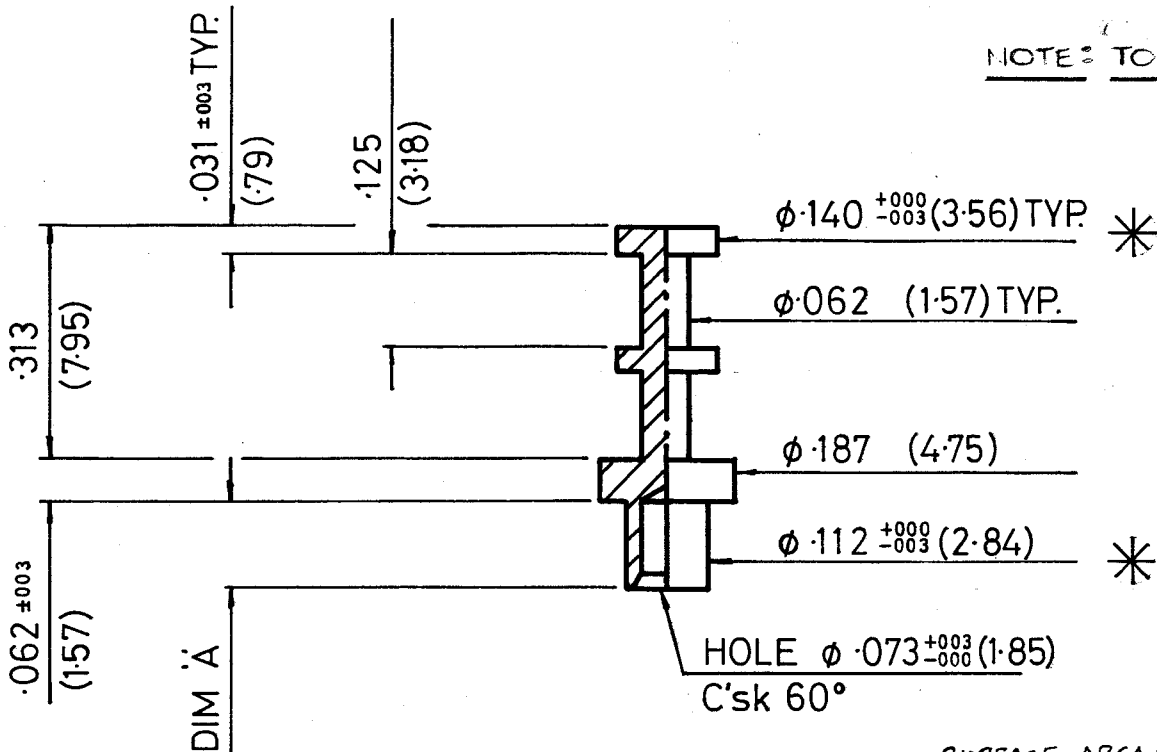

DIMENSIONS MARKED  
THUS \* TO APPLY  
AFTER PLATING

SURFACE AREA (H2122-01) = 152.9 mm<sup>2</sup>

DELETED

<del>H2123-01</del>	<del>156 (3.96)</del>
H2122-01	.125 (3.18)
REF NO	DRG NO
	DIM A <sup>+005</sup> / <sub>-000</sub>

12	19.12.88	1384
11	27/5/86	982
10	20.11.78	WAS MA 1057-2
3	22.8.72	081
ISS.	DATE	CHANGE

APPD. *[Signature]*  
CHKD. *[Signature]*  
DRAWN *[Signature]*

OLD REF.  
H2122-3

ASSY. DRAWING

PT CL27 Esco D61015

**HARWIN ENGINEERS S.A.**  
PORTSMOUTH PO6 1RT

MATERIAL BRASS BS2874 CZ121

TITLE

TERMINAL LUG

FINISH 90/10 TIN/LEAD (FO101)

TOLERANCES  
FRAC. ± 1/64 DEC ± .005 MM ±  
DIMS. IN INCH (mm) SCALE 4:1

DRAWING NUMBER  
H2122-01  
H2123-01